

☐ **APPROVED**

☐ **APPROVED AS NOTED**

☐ **REVISE AND RESUBMIT**

☐ **REJECTED**

This drawing must be checked, signed, and returned before fabrication begins. Please verify all dimensions, equipment positions, finishes, breath guard mounting, and clearances.

SIGNATURE _____ DATE _____


The designs, drawings, renderings, and other documents ("Designs") furnished by The Vollrath Company, L.L.C. ("Vollrath") to you (including anything in electronic format), are owned by Vollrath, its licensors or other providers of those materials and are protected by United States and international copyright, trademark, patent, trade secret, and other intellectual property or proprietary rights laws, as applicable. The Designs may not be duplicated, reproduced, modified, or distributed, without the express written consent of Vollrath. All Designs prepared by Vollrath are provided to you on a confidential basis unless agreed otherwise in writing by Vollrath.

You may not use the Designs for any purpose unless you engage Vollrath to complete the design and construction in accordance with the Design and then only for the purpose of completing the design and construction. It is illegal to reproduce, duplicate, modify, resell, redistribute, lease, loan, or develop derivative work, in whole or in part, from the Designs without the express written consent of Vollrath.



1236 N. 18th Street
Sheboygan, WI 53081
vollrathfoodservice.com

Submittal 615 - 11 40 00 Shop Drawing per RFI 688 REV 02 dated 6/25/21.

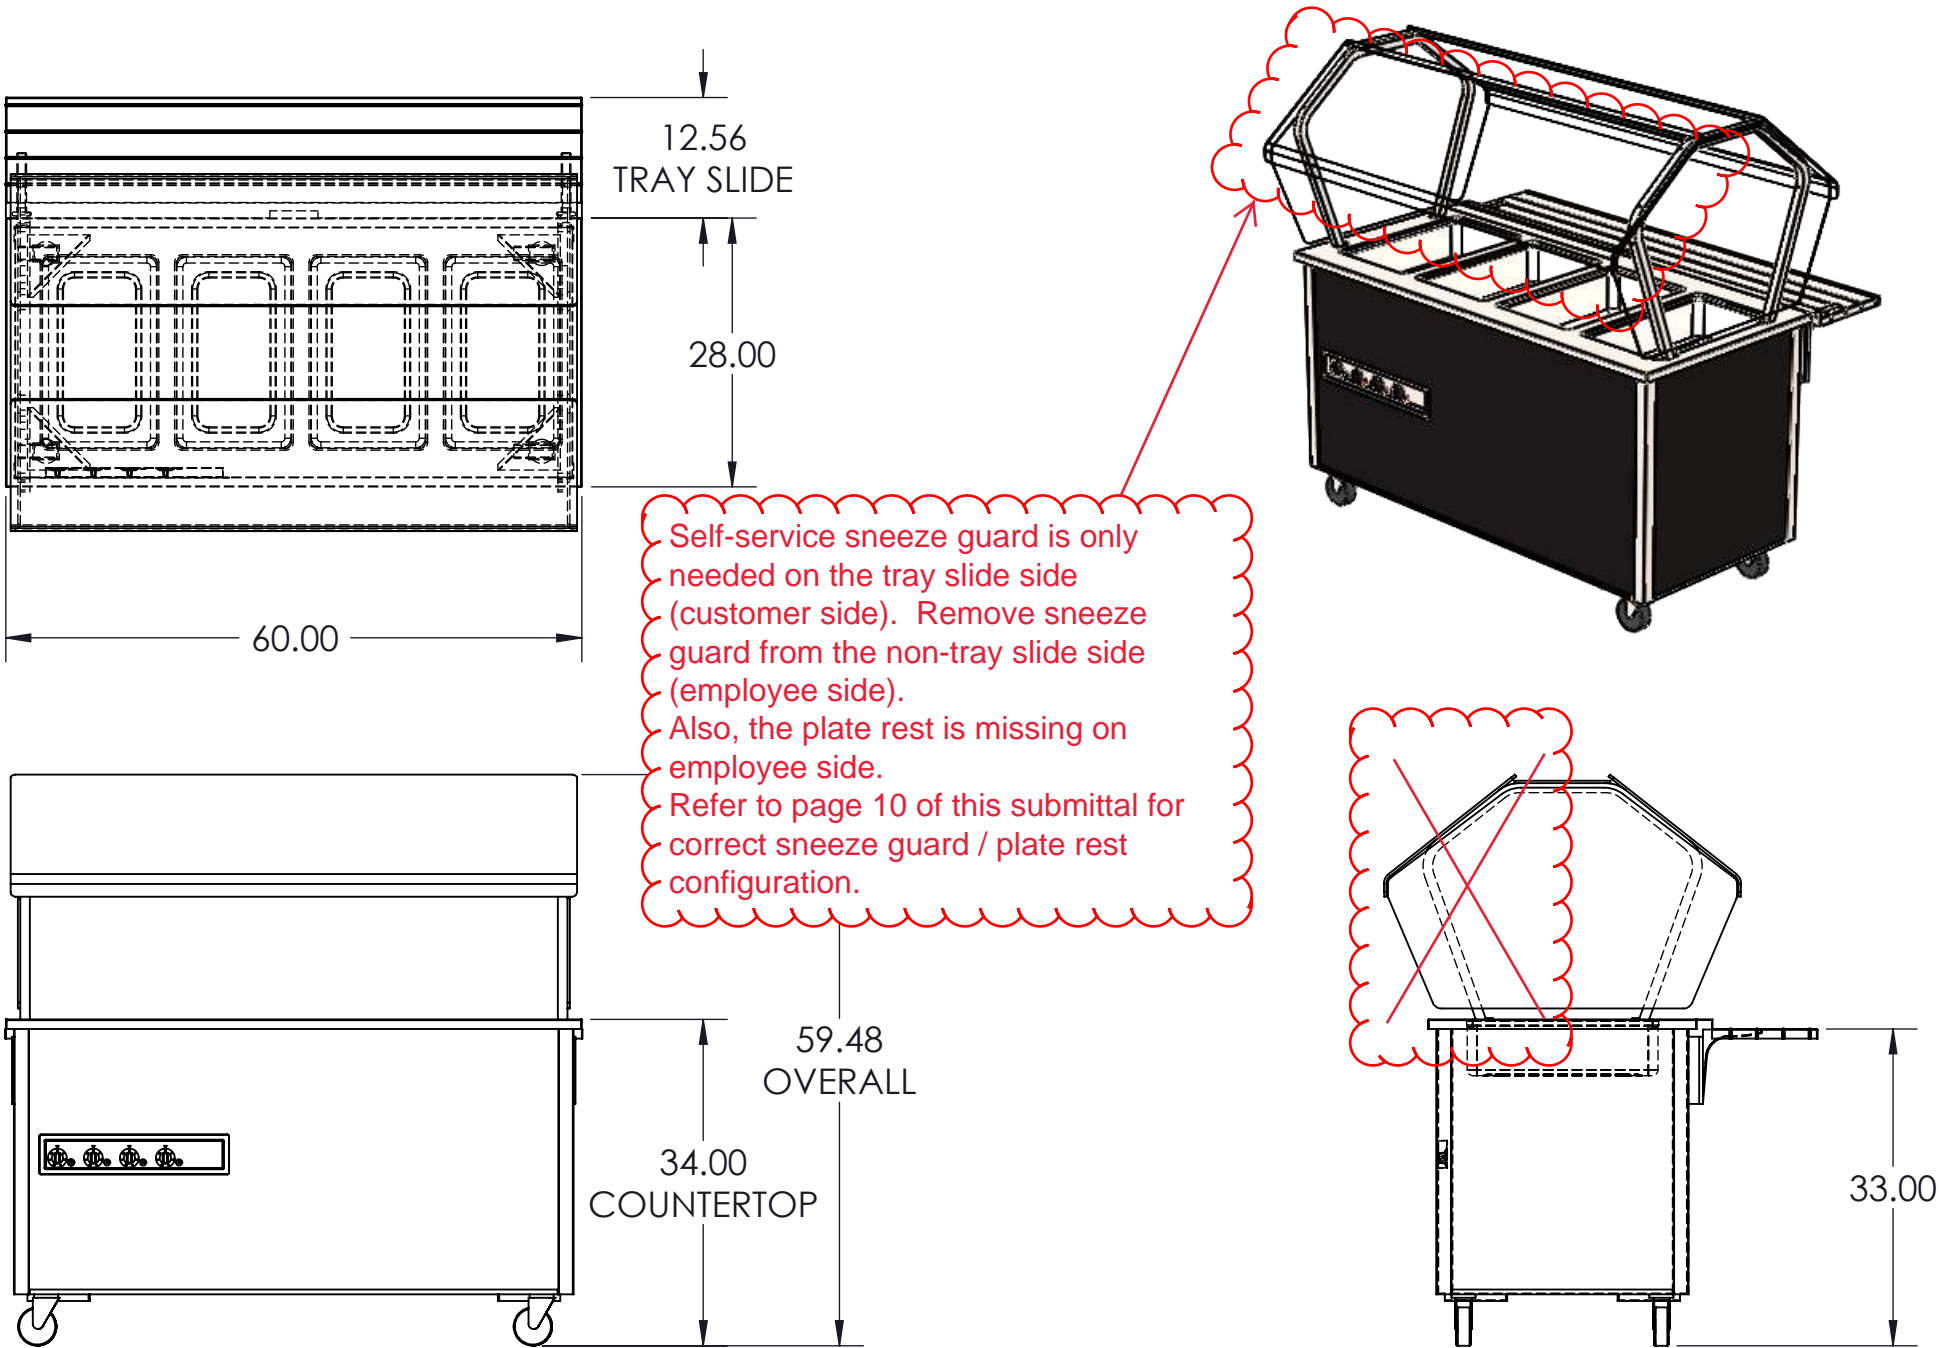

| REVISIONS | | | | |
|-----------|-------------|------|--|--|
| NO. | DESCRIPTION | DATE | | |
| | | | | |
| | | | | |
PB MS

| | |
|-----------------|--------------|
| PROJECT NUMBER: | C-12717 |
| REFERENCE: | |
| DATE: | 7/14/2021 |
| SCALE: | NTS |
| DRAWN BY: | Bill McBride |

SHEET TITLE:
**VOLLRATH
PLAN, FRONT,
SIDE**

SHEET NUMBER
1 of 1

| EQUIPMENT 1 | EQUIPMENT 2 | EQUIPMENT 3 | UNIT VOLTS | UNIT AMPS | UNIT PLUG | BASE FINISH | BASE COLOR |
|-------------|-------------|-------------|------------|-----------|------------|----------------|------------------------------|
| HOT_DRY | NONE | NONE | 208 | 14.5 | NEMA 6-20P | STANDARD BLACK | NEVAMAR_S6053_JETT_BLACK.JPG |